## LABOR AND MATERIALS

1 Copper / Lead } Connection 3/4 ..... $.....

1 Curb { Cock / Valve / T. S. & V. } 3/4 ..... in. ..... $.....

1 Service Box Old returned { Short 3½x4½ / Long 4½x5½ / Buff or Rdway } ..... $.....

11 Ft. 3/4 ..... in. { Copper / Galv Iron / Cast Iron } Pipe at ..... $.....

..... Nipples ..... in. at ..... $.....

..... Bushings ..... to ..... in. at ..... $.....

..... Red'g / Inc'g } Couplings ..... to ..... in. at ..... $.....

..... Union ..... in. at ..... $.....

..... Meter ..... in. at ..... $.....

..... Lead Joints at ..... $.....

..... Leadite Joints at ..... $.....

..... Hrs. Foreman at ..... $.....

..... Hrs. Chauffeur at ..... $.....

..... Hrs. Tapper at ..... $.....

..... Hrs. Labor at ..... $.....

..... Hrs. Labor at ..... $.....

..... Hrs. Compressor at ..... $.....

..... Compensation Ins. ..... $.....

..... Trucking ..... $.....

..... Builders Use of Water ..... $.....


..... $.....

..... $.....

..... $.....

..... $.....

St. Pl. Ave. No. 10 Big Cross

Name of Owner

Norton

Labor and Mat'l. Report Aug 17 1944

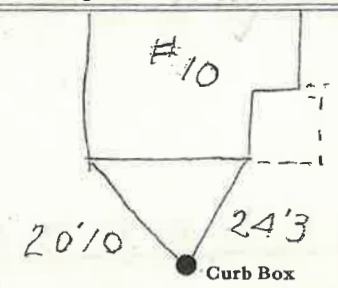


4 Main

Elev. of Main at tap 7

Gate at ●

● Gate at

TAX ID # 309.12-7-19

● Curb Box