LABOR AND MATERIALS

____ Copper / Lead } Connection ____ $ ____

____ Curb { Cock / Valve / T.S. & V. } ____ in. ____ $ ____

____ Service box / Old returned { Short 3-1/2 x 4-1/2 / Long 4-1/2 x 5-1/2 } ____ $ ____

52.6 Ft. 3/4 in. { (Copper) / G.I. / C.I. } Pipe at ____ $ ____

____ Nipples ____ in. at ____ $ ____

____ Bushings ____ to ____ in. at ____ $ ____

____ Red'g

____ Inc'g

____ Union ____ in. at ____ $ ____

____ Meter ____ in. at ____ $ ____

____ ____ $ ____

____ Compound Joints at ____ $ ____

____ Maintenance Foreman ____ $ ____

____ Hrs. Water Maint. Man - 1 at ____ $ ____

____ Hrs. Water Maint. Man - 2 at ____ $ ____

____ Hrs. Garage Foreman ____ at ____ $ ____

____ Hrs. Labor ____ at ____ $ ____

____ Hrs. Compressor at ____ $ ____

____ ____ $ ____

____ Trucking ____ $ ____

____ Pav't Patch ____ $ ____

____ ____ $ ____

____ ____ $ ____

____ ____ $ ____

____ ____ $ ____

$ ____

BOYLSTON (St.) Pl. Ave. No. 14 LOT 63

Name of Owner

Labor and Mat'l. Report 19 DEC 30, 2003

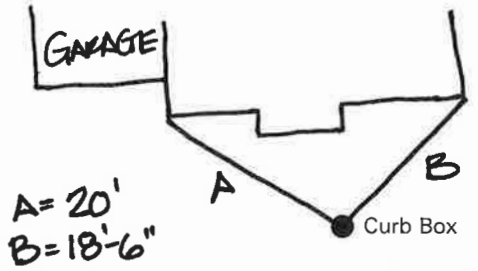

8" Main Elev. of Main at tap 4.75'

Gate at ● ● Gate at
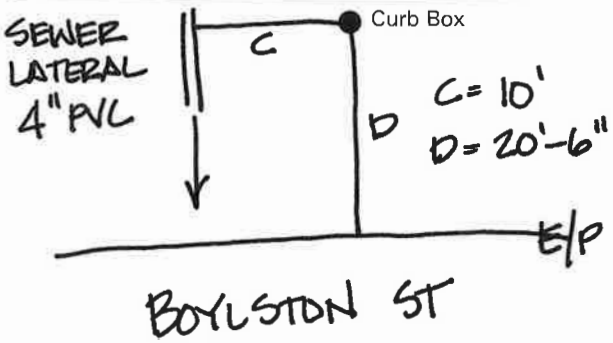
TAX ID# 309.15-16-14