LABOR AND MATERIALS

1	Copper / ~~Lead~~ Connection	3/4"	$ 2.41
1	Curb — Cock / ~~Valve~~ / ~~T. S. & V.~~	3/4 in.	$ 3.41
1	Service box ~~Old returned~~ — Short 3½ x 4½ / ~~Long 4½ x 5½~~ / Buff or Rdway		$ 4.18
9	Ft. 3/4 in. — Copper / ~~C.I.~~ / ~~C.I.~~ Pipe at 40		$ 3.60
	Nipples in. at		$
	Bushings to in. at		$
	Red'g / Inc'g Coupl'gs to in. at		$
	Union in. at		$
	Meter in. at		$
	Lead Joints at		$
	Compound Joints at		$
	Maintenance Foreman		$
	Hrs. Water Maint. Man—1 at		$
2½	Hrs. Water Maint. Man—2 at	1.24	$ 4.34
	Hrs. Garage Foreman at		$
	Hrs. Labor— at		$
	Hrs. Compressor at		$
	Compensation Ins. at $3.861 per C		$ .17
	Trucking		$ 1.50
	Pav't Patch		$ —
Tap by Gifford 11-18-54			$
			$
			$
	O'head		$
			$ 1961

93-54

W. Boylston St. / ~~Pl.~~ Ave. No. 22

Name of Owner David E. Eggleston 1965
~~Burton Reynolds~~

Labor and Mat'l. Report Nov. 18 1954

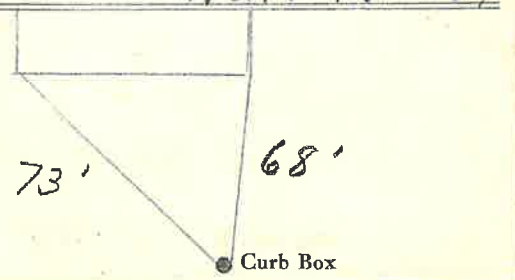

6" Main — Elev. of Main at tap 5'-1"

Gate at • — • Gate at

• Curb Box

LSM—5C—2-1-54