LABOR AND MATERIALS

Copper / Lead } Connection _____ $_____

Curb { Cock / Valve / T. S. & V. } _____ in. _____ $_____

Service box / Old returned { Short 3½ x 4½ / Long 4½ x 5½ } _____ $_____

19 Ft. 3/4 in. { Copper / ~~G.I.~~ / ~~C.I.~~ } Pipe at _____ $_____

Nipples _____ in. at _____ $_____

Bushings _____ to _____ in. at _____ $_____

Red'g / Inc'g } Coupl'gs _____ to _____ in. at _____ $_____

Union _____ in. at _____ $_____

Meter _____ in. at _____ $_____

_____ $_____

Compound Joints at _____ $_____

Maintenance Foreman _____ $_____

Hrs. Water Maint. Man—1 at _____ $_____

Hrs. Water Maint. Man—2 at _____ $_____

Hrs. Garage Foreman _____ at _____ $_____

Hrs. Labor— _____ at _____ $_____

Hrs. Compressor at _____ $_____

_____ $_____

Trucking _____ $_____

Pav't Patch _____ $_____

_____ $_____

_____ $_____

_____ $_____

_____ $_____

$_____

St.
~~Pl.~~
~~Ave.~~ No. 34

Bush

Name of Owner

Labor and Mat'l. Report 1990

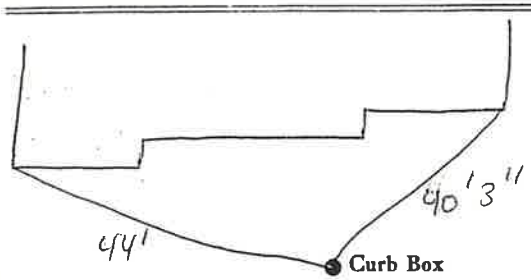

6 Main

Elev. of Main at tap 5'

Gate at ●

● Gate at

● Curb Box

LSM—5C—6-1-67