LABOR AND MATERIALS

1 Copper / ~~Lead~~ Connection 3/4" $____

1 Curb { Cock / ~~Valve~~ / ~~T.S. & V.~~ } 3/4 in. $____

1 Service box { ~~Short 3½ x 4½~~ / Long 4½ x 5½ / ~~Buff or Rdway~~ } $____

~~Old returned~~

25 Ft. 3/4 in. { Copper / ~~G.I.~~ / ~~C.I.~~ } Pipe at $____

____ Nipples ____ in. at $____

____ Bushings ____ to ____ in. at $____

Red'g / Inc'g Coupl'gs ____ to ____ in. at $____

____ Union ____ in. at $____

____ Meter ____ in. at $____

____ Lead Joints at $____

____ Compound Joints at $____

____ Maintenance Foreman $____

____ Hrs. Water Maint. Man—1 at $____

____ Hrs. Water Maint. Man—2 at $____

____ Hrs. Garage Foreman ____ at $____

____ Hrs. Labor— ____ at $____

____ Hrs. Compressor at $____

____ Compensation Ins. at $____ per C $____

____ Trucking $____

____ Pav't Patch $____

$____

$____

$____

$____

____ O'head $____

$____

~~St.~~
~~Pl.~~
Byrne Ave Ave. No. 34

Name of Owner

Robert Soncini

Labor and Mat'l. Report Aug 8 1975

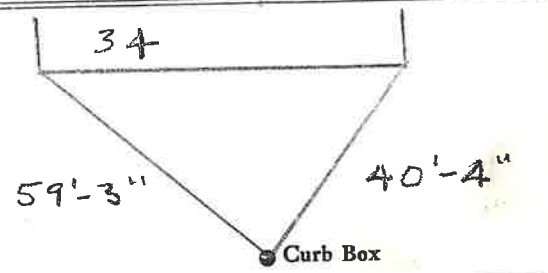

12" Main

Elev. of Main at tap 5½'

Gate at ●

● Gate at

● Curb Box

LSM—5C—6-1-67