LABOR AND MATERIALS

1 Copper / ~~Lead~~ } Connection 3/4" $

1 Curb { Cock / ~~Valve~~ / ~~T. S. & V.~~ } 3/4 in. O-ISEAL $

1 Service box / ~~Old returned~~ { Short 3½ x 4½ / ~~Long 4½ x 5½~~ / ~~Buff or Rdway~~ } $

26 Ft. 3/4 in. { Copper / ~~G. I.~~ / ~~C. I.~~ } Pipe at $

Nipples in. at $

Bushings to in. at $

Red'g / Inc'g } Coupl'gs to in. at $

Union in. at $

Meter in. at $

Lead Joints at $

Compound Joints at $

Maintenance Foreman $

Hrs. Water Maint. Man—1 at $

Hrs. Water Maint. Man—2 at $

Hrs. Garage Foreman at $

Hrs. Labor— at $

Hrs. Compressor at $

Compensation Ins. at $ per C $

Trucking $

Pav't Patch $

Tap by Giseard & Kelly $

$

O'head 6-17-64 $

$

Byrne St. / Pl. / Ave. No. 12

Name of Owner

Edward Gray.

Labor and Mat'l. Report June 17 1964

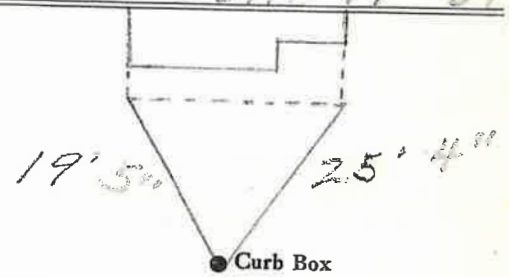

12" Main

Elev. of Main at tap 5'

Gate at ●

● Gate at

TAX ID # 303.13-10-2

● Curb Box

LSM—5C—9-10-61