LABOR AND MATERIALS

1 Copper / Lead } Connection 3/4" $_____

1 Curb { Cock / Valve / T. S. & V. } 3/4 in. Oriseal $_____

1 Service box / Old returned { Short 3½ x 4½ / Long 4½ x 5½ / Buff or Rdway } 3'x4' _____ $_____

14 Ft. 3/4 in. { Copper / C. I. / C. I. } Pipe at _____ $_____

_____ Nipples _____ in. at _____ $_____

_____ Bushings _____ to _____ in. at _____ $_____

_____ Red'g / Inc'g } Coupl'gs _____ to _____ in. at _____ $_____

_____ Union _____ in. at _____ $_____

_____ Meter _____ in. at _____ $_____

_____ Lead Joints at _____ $_____

_____ Compound Joints at _____ $_____

_____ Maintenance Foreman _____ $_____

_____ Hrs. Water Maint. Man—1 at _____ $_____

_____ Hrs. Water Maint. Man—2 at _____ $_____

_____ Hrs. Garage Foreman _____ at _____ $_____

_____ Hrs. Labor— _____ at _____ $_____

_____ Hrs. Compressor at _____ $_____

_____ Compensation Ins. at $_____ per C _____ $_____

_____ Trucking _____ $_____

_____ Pav't Patch _____ $_____

Tap by Lareau Co. $_____

_____ $_____

12-7-65. $_____

_____ O'head _____ $_____

$_____

Byrne St. Pl. Ave. No. 19

Name of Owner

Ed. Greenwood.

Labor and Mat'l. Report Dec. 7 1965

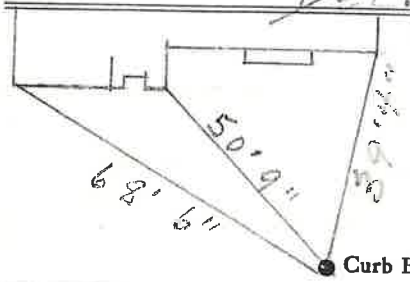

12" CI Main

Elev. of Main at tap 3½'

Gate at ●

● Gate at

● Curb Box

LSM—EC—3-10-61