LABOR AND MATERIALS

1	Copper ~~Lead~~ Connection	3/4	$ 2.80
1	Curb { Clock, Valve, ~~T. S. & V.~~ }	3/4 in.	$ 3.60
1	Service box, Old returned { ~~Short 3½X4½~~, ~~Long 4½X6½~~, Buff or Rdway }	Same	$ —
18 Ft.	3/4 in. { Copper, Galv. Iron, Cast Iron } Pipe at	35	$ 6.30
	Nipples ... in. at		$
	Bushings ... to ... in. at		$
	Red'g, Inc'g Couplings ... to ... in. at		$
	Union ... in. at		$
	Meter ... in. at		$
	Lead Joints at		$
	Compound Joints at		$
1	Hrs. Foreman at		$
1	Hrs. Chauffeur at	91	$ 91
2	Hrs. Tapper at	91	$ 1.82
16	Hrs. Labor at	80	$ 12.80
	Hrs. Labor at		$
1	Hrs. Compressor at	87½	$ .88
	Compensation Ins.		$ .34
	Trucking		$
	Builders Use of Water		$ 4.70
	Tap by Magnum		$
			$
			$
			$
			$ 35.15

151 / 17

Center

St.
Pl.
Ave. No. ~~E~~ "

Name of Owner

Arenson

Labor and Mat'l. Report Nov 10 19 47

RAZED
1996

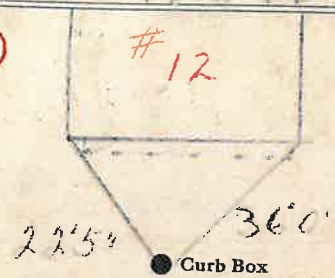

4 Main

Elev. of Main at tap 6

Gate at ●

● Gate at

● Curb Box

LSM-5C-6-1-45