LABOR AND MATERIALS

1	Copper / Lead Connection 3/4	$ 2.29	
1	Curb Cock / Valve / T. S. & V. 3/4 in.	$ 2.70	
1	Service box Old returned Short 3½x4½ / ~~Long 4½x5½~~ / Buff or Rdway	$ 4.25	
12	Ft. 3/4 in. Copper / ~~G. I.~~ / ~~C. I.~~ Pipe at 35	$ 4.20	
	Nipples in. at	$	
	Bushings to in. at	$	
	Red'g / Inc'g Coupl'gs to in. at	$	
	Union in. at	$	
	Meter in. at	$	
	Lead Joints at	$	1.24
	Compound Joints at	$	
1½	Hrs. Water Maint. Man—1 at 1.12	$ 1.68	
3	Hrs. Water Maint. Man—2 at 1.02	$ 3.06	
10½	Hrs. Labor— at 91	$ 9.55	
	Hrs. Labor— at	$	
	Hrs. Compressor at	$	
	Compensation Ins. at $ per C.	$ .32	
	Trucking	$ 1.—	
	Pav't Patch B. P.	$	
		$	
		$	
		$	
	O'head	$	
		$ 29.05	

Before Paving

St. ~~Pl.~~ ~~Ave.~~ No. 4

Charlotte

Name of Owner

Philip Rose

Labor and Mat'l. Report July 7 1950

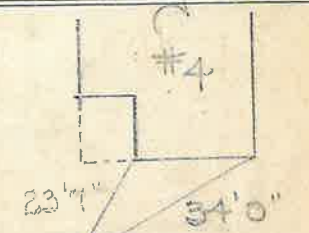

4" Main

Elev. of Main at tap 5'

Gate at ●

● Gate at

TAX ID # 302.20-3-1

● Curb Box

LSM-5C 10-21-49

Before paving