LABOR AND MATERIALS

1	Copper / ~~Lead~~ } Connection 3/4	$ 1.35
1	Curb { Cock / Valve / T. S. & V. } 3/4 in.	$ 1.80
1	Service Box Old returned { Short 3½x4½ / Long 4½x5½ / Buff or Rdway }	$ 1.70
11	Ft. 3/4 in. { Copper / ~~Galv Iron~~ / ~~Cast Iron~~ } Pipe at 18	$ 1.98
	Nipples ... in. at	$
	Bushings ... to ... in. at	$
	Red'g / Inc'g } Couplings ... to ... in. at	$
	Union ... in. at	$
	Meter ... in. at	$
	Lead Joints at	$
	Leadite Joints at	$
	Hrs. Foreman at	$
2	Hrs. Chauffeur at 62½	$ 1.25
7	Hrs. Tapper at	$ 4.38
	Hrs. Labor at	$
	Hrs. Labor at	$
1	Hrs. Compressor at	$ .63
	Compensation Ins.	$ 18
	Trucking	$ 1.—
	Builders Use of Water Patch	$ 5.—
		$
		$
		$
		$
		$ 19.27

42 1941

St. 42
~~Pl.~~
Cherry Ave. No. 32

Name of Owner
Baptista

Labor and Mat'l. Report Nov 12 1941

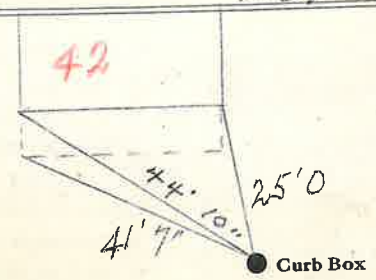

12 Main

Elev. of Main at tap 5

Gate at ●

● Gate at

● Curb Box