LABOR AND MATERIALS

1	Copper ~~Lead~~ Connection	3/4	$ 1.78
1	Curb { Clock / ~~Valve~~ / ~~T. S. & V.~~ }	3/4 in.	$ 2.61
1	Service box ~~Old returned~~ { ~~Short 3½X4½~~ / Long 4½X5¾ / Buff or ~~Rdway~~ }		$ 1.82
9 Ft.	3/4 in. { Copper / ~~Galv. Iron~~ / ~~Cast Iron~~ }	Pipe at 23	$ 2.07
	Nipples in. at		$
	Bushings to in. at		$
	Red'g / Inc'g Couplings to in. at		$
	Union in. at		$
	Meter in. at		$
	Lead Joints at		$
	Compound Joints at		$
	Hrs. Foreman at		$
7	Hrs. Chauffeur at 7.5		$ 5.25
6	Hrs. Tapper at		$ 4.50
~~20~~	Hrs. Labor at 6.5		$ 13.00
	Hrs. Labor at		$
	Hrs. Compressor at		$
	Compensation Ins.		$ .63
	Trucking		$ 1.00
	Builders Use of Water	1	$ 5.00
Tap by Warsinski			$
			$
			$
			$
			$ 37.66

✓

25-46

St. / ~~Pl.~~ / ~~Ave.~~ No. 11 / 9

Cherry

Name of Owner

DeSare

Labor and Mat'l. Report May 16 1946

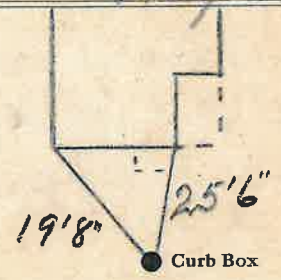

1 Main

Elev. of Main at tap 6

Gate at ●

● Gate at

● Curb Box

LSM-5C-6-1-45