LABOR AND MATERIALS

1 Copper / ~~Lead~~ } Connection 1½ in $

1 Curb { Cock / ~~Valve~~ / ~~T. S. & V.~~ } 2 in. $

1 Service box { ~~Short 3½ x 4½~~ / ~~Long 4½ x 5½~~ / Buff or Rdway } $

30 Ft. 2 in. { Copper / ~~C. I.~~ / ~~G. I.~~ } Pipe at $

Nipples in. at $

Bushings to in. at $

Red'g / Inc'g } Coupl'gs to in. at $

Union in. at $

Meter in. at $

Lead Joints at $

Compound Joints at $

Maintenance Foreman $

Hrs. Water Maint. Man—1 at $

Hrs. Water Maint. Man—2 at $

Hrs. Garage Foreman at $

Hrs. Labor— at $

Hrs. Compressor at $

Compensation Ins. at $ per C $

Trucking $

Pav't Patch $

$

Tap Apr 21, 1980 $

W. Metz & Co. $

O'head $

$

Church St. / ~~Pl.~~ / ~~Ave.~~ No.

Name of Owner

City of Glens Falls

Labor and Mat'l. Report April 21, 1980

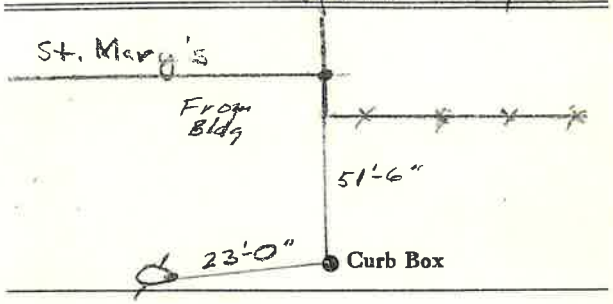

6" Main

Elev. of Main at tap 5-1

Gate at •

• Gate at

• Curb Box

LSM—5C—6-1-67