LABOR AND MATERIALS

1	Copper / ~~Lead~~ Connection 3/4"		$ 3.04
1	Curb Cock / Valve / T. S. & V. 3/4" in.		$ 3.54
1	Service box / Old returned Short 3½x4½ / ~~Long 4½x5½~~ / Buff or Rdway		$ 4.70
27	Ft. 3/4 in. Copper / G. I. / C. I. Pipe at 35		$ 9.54
	Nipples in. at		$
	Bushings to in. at		$
	Red'g / Inc'g Coupl'gs to in. at		$
	Union in. at		$
	Meter in. at		$
	Lead Joints at		$ 4.30
	Compound Joints at		$
	Hrs. Water Maint. Man—1 at		$
2	Hrs. Water Maint. Man—2 at	1.13	$ 2.26
2	Hrs. Labor— at	1.02	$ 2.04
	Hrs. Labor— at		$
	Hrs. Compressor at		$
	Compensation Ins. at $ per C.		$ .11
	Trucking		$ 1.00
	Pav't Patch B.P.		$
			$
			$
			$
	O'head		$
			$ 26.23

New Tap made by Gifford June 20-1951

96-1951

Clayton ~~St.~~ ~~Pl.~~ ~~Acena~~ Ave. No. 22

Name of Owner William N. Smith

Labor and Mat'l. Report June 20 1951

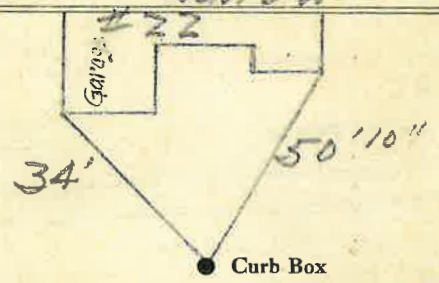

6" Main

Elev. of Main at tap ~~5½'~~ ? 7

Gate at ● ● Gate at

TAX ID # 302.19-13-4

● Curb Box

LSM-5C 10-21-49