Labor and Materials

1 Copper / Lead } Connection 3/4" ..... $

1 Curb { Cock / Valve / T. S. & V. } 3/4 in ..... $

1 Service Box, Old returned { Short 3½ x 4½ / Long 4½ x 5½ / Buff. or Rdway } ..... $

19 Ft. 3/4 in. { Copper / Galv Iron / Cast Iron } Pipe at ..... $

..... Nipples ..... in. at ..... $

..... Bushings ..... to ..... in. at ..... $

Red'g / Inc'g { Couplings ..... to ..... in. at ..... $

..... Union ..... in. at ..... $

..... Meter ..... in. at ..... $

..... Lead Joints at ..... $

..... Leadite Joints at ..... $

..... Hrs. Foreman at ..... $

..... Hrs, Chauffeur at ..... $

..... Hrs. Tapper at ..... $

..... Hrs. Labor at ..... $

..... Hrs. Labor at ..... $

..... Hrs. Compressor at ..... $

..... Compensation Ins. ..... $

..... Trucking ..... $

..... Builders Use of Water ..... $

..... $

..... $

..... $

..... $

$

1 Clinton St. / Pl. / Ave. No. 1

Name of Owner

Rice

Measured in

Labor and Mat'l. Report Jan 28 1937

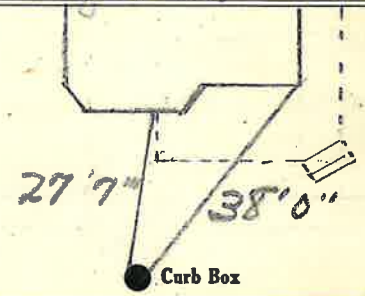

..... Main Elev. of Main at tap ....

Gate at ● ● Gate at

● Curb Box

This Place Razed & Shut off at Curb June 5-56.
Dug up & disconnected at main July 31-65