COOLIDGE ~~St.~~ ~~Pl.~~ Ave. No. 43

Name of Owner

DR. MORRIS MASLON

Labor and Mat'l. Report 6-28 1937

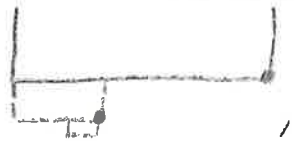

● Curb Box

6" Main

Elev. of Main at tap 5'

Gate at ●

● Gate at

12' to main

3/4" COPPER

● Curb Box

OLD SHUT OFF

LSM—5C—6-1-67

LABOR AND MATERIALS

1 Copper / ~~Lead~~ } Connection 3/4 $

1 Curb { Cock / Valve / T. S. & V. } 3/4 in. $

1 Service box { Short 3½ x 4½ / ~~Long 4½ x 5½~~ } Old returned

$

12 Ft. 3/4 in. { Copper / ~~C. I.~~ / ~~C. I.~~ } Pipe at $

Nipples in. at $

Bushings to in. at $

{ Red'g / Inc'g } Coupl'gs to in. at $

Union in. at $

Meter in. at $

$

Compound Joints at $

Maintenance Foreman $

Hrs. Water Maint. Man—1 at $

Hrs. Water Maint. Man—2 at $

Hrs. Garage Foreman at $

Hrs. Labor— at $

Hrs. Compressor at $

$

Trucking $

Pav't Patch $

$

$

$

$