COOLIDGE ~~St.~~ ~~Pl.~~ Ave. No. 50

Name of Owner

Labor and Mat'l. Report 11-25 1929

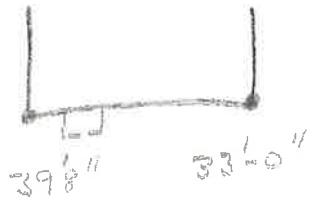

● Curb Box

6" Main

Elev. of Main at tap 5'

Gate at ●

● Gate at

● Curb Box

LSM—5C—6-1-67

LABOR AND MATERIALS

1 Copper ~~Lead~~ } Connection 3/4 $

1 Curb { Cock ~~Valve~~ ~~T. S. & V.~~ } 3/4 in. $

1 Service box ~~Old returned~~ { Short 3½ x 4½ ~~Long 4½ x 5½~~ } $

9 Ft. 3/4 in. { Copper ~~C. I.~~ ~~C. I.~~ } Pipe at $

Nipples in. at $

Bushings to in. at $

Red'g Inc'g } Coupl'gs to in. at $

Union in. at $

Meter in. at $

$

Compound Joints at $

Maintenance Foreman $

Hrs. Water Maint. Man—1 at $

Hrs. Water Maint. Man—2 at $

Hrs. Garage Foreman at $

Hrs. Labor— at $

Hrs. Compressor at $

$

Trucking $

Pav't Patch $

$

$

$

$

$