~~St.~~
~~Pl.~~

Coolidge Ave. No. 55

Name of Owner

West, J.

Labor and Mat'l. Report June 9 19 22

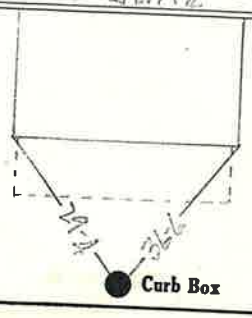

Main

Elev. of Main at tap

Gate at ● ● Gate at

● Curb Box

Labor and Materials

1 ~~Copper~~ Lead } Connection 1/2" $

1 Curb { Cock / ~~Valve~~ / ~~T. S. & W.~~ } 3/4" in $

1 Service Box { Short 3½ x 4½ / ~~Long 4½ x 5½~~ / ~~Buff. or Rdway~~ } $

43 Ft. 3/4 in. { ~~Copper~~ / Galv Iron / ~~Cast Iron~~ } Pipe at $

Nipples in. at $

Bushings to in. at $

Red'g / Inc'g } Couplings to in. at $

Union in. at $

Meter in. at $

Lead Joints at $

Leadite Joints at $

Hrs. Foreman at $

Hrs. Chauffeur at $

Hrs. Tapper at $

Hrs. Labor at $

Hrs. Labor at $

Hrs. Compressor at $

Compensation Ins. $

Trucking $

Builders Use of Water $

$

$

$

$

$