COOLIDGE ~~St.~~ ~~Pl.~~ Ave. No. 56

Name of Owner

Labor and Mat'l. Report DEC 16 1935

41'5" 36'-0"

● Curb Box

6" Main

Elev. of Main at tap 4½'

Gate at ●

● Gate at

● Curb Box

NEW HOUSE

LSM—5C—6-1-67

LABOR AND MATERIALS

1 Copper / ~~Lead~~ Connection 3/4 $

1 Curb Cock / ~~Valve~~ / ~~T. S. & V.~~ 3/4 in. $

1 Service box Short 3½ x 4½ / ~~Long 4½ x 5½~~ / ~~Old returned~~ $

9 Ft. 3/4 in. Copper / ~~G. I.~~ / ~~C. I.~~ Pipe at $

Nipples in. at $

Bushings to in. at $

Red'g / Inc'g Coupl'gs to in. at $

Union in. at $

Meter in. at $

$

Compound Joints at $

Maintenance Foreman $

Hrs. Water Maint. Man—1 at $

Hrs. Water Maint. Man—2 at $

Hrs. Garage Foreman at $

Hrs. Labor— at $

Hrs. Compressor at $

$

Trucking $

Pav't Patch $

$

$

$

$

$

Coolidge Ave St. Pl. Ave. No. 56

Name of Owner

Labor and Mat'l. Report 19

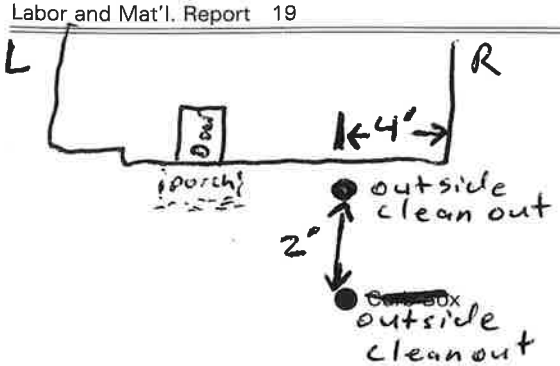

_____ Main

Elev. of Main at tap _____

Gate at ● _____

● Gate at _____

● Curb Box

LABOR AND MATERIALS

_____ Copper / Lead } Connection _____ $ _____

_____ Curb } Cock / Valve / T.S. & V. } _____ in. _____ $ _____

_____ Service box / Old returned { Short 3-1/2 x 4-1/2 / Long 4-1/2 x 5-1/2 } _____ $ _____

_____ Ft. _____ in. { Copper / G.I. / C.I. } Pipe at _____ $ _____

_____ Nipples _____ in. at _____ $ _____

_____ Bushings _____ to _____ in. at _____ $ _____

_____ Red'g

_____ Inc'g

_____ Union _____ in. at _____ $ _____

_____ Meter _____ in. at _____ $ _____

_____ _____ $ _____

_____ Compound Joints at _____ $ _____

_____ Maintenance Foreman _____ $ _____

_____ Hrs. Water Maint. Man - 1 at _____ $ _____

_____ Hrs. Water Maint. Man - 2 at _____ $ _____

_____ Hrs. Garage Foreman _____ at _____ $ _____

_____ Hrs. Labor _____ at _____ $ _____

_____ Hrs. Compressor at _____ $ _____

_____ _____ $ _____

_____ Trucking _____ $ _____

_____ Pav't Patch _____ $ _____

_____ _____ $ _____

_____ _____ $ _____

_____ _____ $ _____

_____ _____ $ _____

$ _____