~~St.~~
~~Pl.~~ COOLIDGE Ave. No. 57

Name of Owner

MANZIE

Labor and Mat'l. Report AUG 23 1938

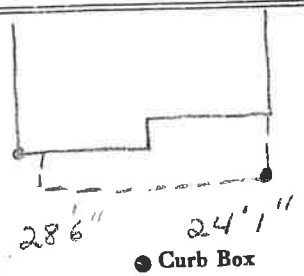

● Curb Box

6" Main

Elev. of Main at tap 4½'

Gate at ●

● Gate at

● Curb Box

OLD SHUT OFF

LSM—5C—6-1-67

LABOR AND MATERIALS

1 Copper / ~~Lead~~ } Connection 3/4 $

1 Curb { Cock / ~~Valve~~ / ~~T. S. & V.~~ } 3/4 in. $

1 Service box { ~~Short 3½ x 4½~~ / Long 4½ x 5½ } Old returned $

35 Ft. 3/4 in. { Copper / ~~C.I.~~ / ~~C.I.~~ } Pipe at $

Nipples in. at $

Bushings to in. at $

Red'g / Inc'g } Coupl'gs to in. at $

Union in. at $

Meter in. at $

$

Compound Joints at $

Maintenance Foreman $

Hrs. Water Maint. Man—1 at $

Hrs. Water Maint. Man—2 at $

Hrs. Garage Foreman at $

Hrs. Labor— at $

Hrs. Compressor at $

$

Trucking $

Pav't Patch $

$

$

$

$

$