1 1 8 - 1940

St.
~~Pl.~~
Coolidge Ave. No. 87

Name of Owner
Glass

Labor and Mat'l. Report Oct 18 1940

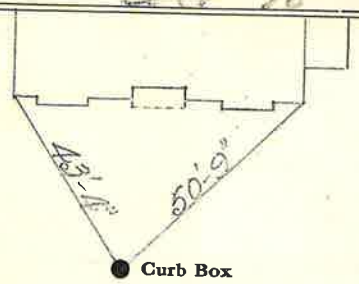

12" Main

Elev. of Main at tap 4 7/12

Gate at ●

● Gate at

Think this house is in Quincy

LABOR AND MATERIALS

1	Copper / ~~Lead~~ Connection 3/4	$ 1.31
1	Curb { Cock / ~~Valve~~ / ~~T. S. & V.~~ } 3/4 in.	$ 1.75
1	Service Box ~~Old~~ returned { Short 3½x4½ / Long 4½x5½ / Buff. or Rdway }	$ 1.60
40	Ft. 3/4 in. { Copper / ~~Galv. Iron~~ / ~~Cast Iron~~ } Pipe at 18	$ 7.20
	Nipples ____ in. at	$
	Bushings ____ to ____ in. at	$
	Red'g / Inc'g } Couplings ____ to ____ in. at	$
	Union ____ in. at	$
	Meter ____ in. at	$
	Lead Joints at	$
	Leadite Joints at	$
	Hrs. Foreman at	$
8	Hrs. Chauffeur at .62½	$ 5.—
	Hrs. Tapper at	$
18	Hrs. Labor at .45	$ 8.10
	Hrs. Labor at	$
	Hrs. Compressor at	$
	Compensation Ins.	$ .40
	Trucking	$ 1.—
	Builders Use of Water no patch	$
	Tap by Person. (outside)	$
		$
		$
		$
		$ 26.36

48