2 2 - - 1939

~~St.~~
~~Pl.~~
Coolidge Ave. No. 89

Name of Owner

Bush

Labor and Mat'l. Report May 24 1939

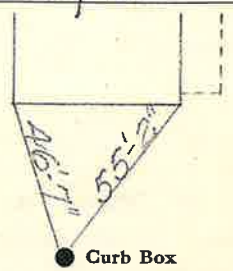

12" Main

Elev. of Main at tap 4½'

Gate at ●

● Gate at

Think the house is in Queensbury

LABOR AND MATERIALS

1 Copper ~~Lead~~ } Connection 3/4" $ 1.23

1 Curb { Cock ~~Valve~~ ~~T. S. & V.~~ } 3/4 in. $ 1.68

1 Service Box ~~Old returned~~ { ~~Short 3½x4½~~ Long 4½x5½ ~~Buff. or Rdway~~ } $ 1.54

37 Ft. 3/4 in. { Copper ~~Galv Iron~~ ~~Cast Iron~~ } Pipe at 17 $ 6.29

Nipples ____ in. at ____ $

Bushings ____ to ____ in. at ____ $

Red'g / Inc'g } Couplings ____ to ____ in. at ____ $

Union ____ in. at ____ $

Meter ____ in. at ____ $

Lead Joints at ____ $

Leadite Joints at ____ $

Hrs. Foreman at ____ $

5 Hrs. Chauffeur at 62½ $ 3.13

7 Hrs. Tapper at – $ 4.37

9 Hrs. Labor at 45 $ 4.05

Hrs. Labor at ____ $

Hrs. Compressor at ____ $

Compensation Ins. ____ $ .36

Trucking ____ $ 1.00

Builders Use of Water no patch $ —

Tap by Hessel

$ 23.65

68