LABOR AND MATERIALS

1 Copper Lead	Connection 3/4	$ 1.80
1 Curb { Cock Valve T. S. & V. }	3/4 in.	$ 1.91
1 Service Box Old returned	{ Short 3⅛x4⅛ Long 4⅛x5⅛ Buff or Rdway }	$ 1.82
9 Ft. 3/4 in.	{ Copper Galv Iron Cast Iron } Pipe at Ft.	$ 1.72
Nipples	in. at	$
Bushings	to in. at	$
Red'g Inc'g	Couplings to in. at	$
Union	in. at	$
Meter	in. at	$
Lead Joints at		$
Leadite Joints at		$
Hrs. Foreman at		$
2 Hrs. Chauffeur at	68¾	$ 1.38
Hrs. Tapper at		$
6 Hrs. Labor at	.60	$ 3.60
Hrs. Labor at		$
1 Hrs. Compressor at	87½	$ .88
Compensation Ins.		$ .13
Trucking		$ 1.10
Builders Use of Water		$ 5.85
Taps by Miller		$
		$
		$
		$
		$20.14

33-49

St. 86
Pl.
Ave. No. 62

Copper

Name of Owner

Del Bigware

Labor and Mat'l. Report Oct 30 19 11

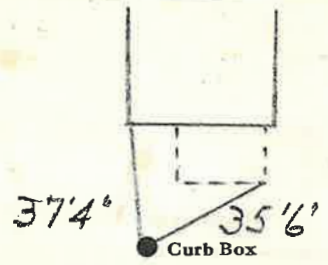

1 Main

Elev. of Main at tap 6

Gate at ●

● Gate at

TAX ID # 303.13-9-1

● Curb Box