LABOR AND MATERIALS

1	Copper ~~Lead~~ { Connection	3/4	$ 2.29
1	Curb { Cock ~~Valve~~ ~~T. S. & V.~~ }	3/4 in.	$ 2.70
1	Service box ~~Old returned~~ { Short 3½x4½ ~~Long 4½x5½~~ ~~Buff or Rdway~~ }		$ 4.25
9	Ft. 3/4 in. { Copper ~~C. I.~~ ~~C. I.~~ } Pipe at	35	$ 3.15
	Nipples in. at		$
	Bushings to in. at		$
	Red'g Inc'g { Coupl'gs to in. at		$
	Union in. at		$
	Meter in. at		$
	Lead Joints at		$
	Compound Joints at		$
	Hrs. Water Maint. Man—1 at		$
4	Hrs. Water Maint. Man—2 at	1.02	$ 4.08
8	Hrs. Labor— at	.91	$ 7.28
	Hrs. Labor— at		$
2	Hrs. Compressor at	1.20	$ 2.40
	Compensation Ins. at $ per C.		$ .25
	Trucking		$ 1.—
	Pav't Patch		$ 12.15
	Tap by Marsinski		$
			$
			$
	O'head		$
			$ 39.55

St. Pl. Ave. No. Cooper St 90

Name of Owner

Cifone

Labor and Mat'l. Report May 18 19 50

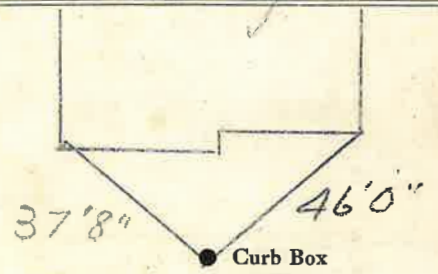

4 Main

Elev. of Main at tap 5

Gate at ● ● Gate at

TAX ID # 303.13-9-3

● Curb Box

LSM-5C 10-21-49