LABOR AND MATERIALS

1	Copper / ~~Lead~~ Connection	3/4	$ 1.59
1	Curb { Cock / ~~Valve~~ / ~~T. S. & V.~~ }	3/4 in.	$ 2.74
1	Service Box Old returned { Short 3⅛x4⅛ / ~~Long 4⅛x5⅛~~ / ~~Buff or Rdway~~ }		$ 1.92
10	Ft. 3/4 in. { Copper / ~~Galv Iron~~ / ~~Cast Iron~~ } Pipe at 19		$ 1.90
	Nipples in. at		$
1	Bushings 1½ to ¾ in. at		$ .10
	Red'g / Inc'g Couplings to in. at		$
	Union in. at		$
	Meter in. at		$
	Lead Joints at		$
	Leadite Joints at		$
	Hrs. Foreman at		$
9	Hrs. Chauffeur at 68¾		$ 6.19½
	Hrs. Tapper at		$
7	Hrs. Labor at 62½		$ 4.37½
	Hrs. Labor at		$
1	Hrs. Compressor at 87½		$ .88
	Compensation Ins.		$ .28
	Trucking		$ 1.00
	Builders Use of Water ?		$ .50
	Tapping Main		$
			$
			$
			$
			$ 25.79

+

5-45

St. 98
Pl.
Ave. No. ~~74~~

Cooper

Name of Owner

Labor and Mat'l. Report Oct 17 1945

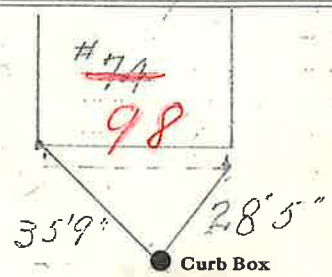

6" Main

Elev. of Main at tap 5'

Gate at ●

● Gate at

TAX ID # 303.13-9-7

● Curb Box