COOPER St. ~~Pl.~~ ~~Ave.~~ No. 15AB

Name of Owner

TAX ID # 303.17-13-12

Labor and Mat'l. Report NOV 13 19 25

4'0" 11'8"

● Curb Box

4" Main

Elev. of Main at tap 6'

Gate at ●

● Gate at

● Curb Box

LSM—5C—6-1-67

LABOR AND MATERIALS

1 ~~Copper~~ Lead } Connection 1" $

1 Curb } ~~Cock~~ Valve ~~T.B.&~~ V. } 1 1/4" in. $

1 Service box ~~Old returned~~ { ~~Short 3½ x 4½~~ Long 4½ x 5½ } $

Ft. in. { Copper G. I. C. I. } Pipe at NO PIPE USED $

Nipples in. at $

Bushings to in. at $

Red'g Inc'g } Coupl'gs to in. at $

Union in. at $

Meter in. at $

$

Compound Joints at $

Maintenance Foreman $

Hrs. Water Maint. Man—1 at $

Hrs. Water Maint. Man—2 at $

Hrs. Garage Foreman at $

Hrs. Labor— at $

Hrs. Compressor at $

$

Trucking $

Pav't Patch $

$

$

$

$

$

COOPER

Name of Owner

St.
Pl.
Ave. No. 15

Labor and Mat'l. Report 4/11/13

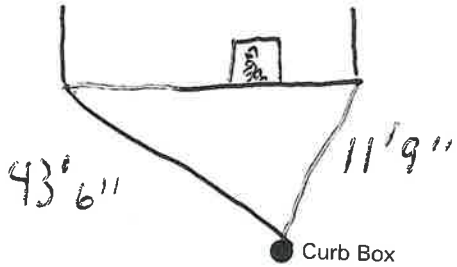

4" Main

Elev. of Main at tap 6'

~~Gate at~~

Gate at

WATER MAIN G.I.

Curb Box

LABOR AND MATERIALS

1 Copper / Lead Connection _____ $ _____

_____ Curb { Cock / Valve / T.S. & V. } _____ in. _____ $ _____

_____ Service box Old returned { Short 3-1/2 x 4-1/2 / Long 4-1/2 x 5-1/2 } _____ $ _____

27' Ft. ____ in. { Copper / G.I. / C.I. } Pipe at _____ $ _____

_____ Nipples _____ in. at _____ $ _____

_____ Bushings _____ to _____ in. at _____ $ _____

_____ Red'g

_____ Inc'g

_____ Union _____ in. at _____ $ _____

_____ Meter _____ in. at _____ $ _____

_____ _____ $ _____

_____ Compound Joints at _____ $ _____

_____ Maintenance Foreman _____ $ _____

_____ Hrs. Water Maint. Man - 1 at _____ $ _____

_____ Hrs. Water Maint. Man - 2 at _____ $ _____

_____ Hrs. Garage Foreman _____ at _____ $ _____

_____ Hrs. Labor _____ at _____ $ _____

_____ Hrs. Compressor at _____ $ _____

_____ _____ $ _____

_____ Trucking _____ $ _____

_____ Pav't Patch _____ $ _____

_____ _____ $ _____

_____ _____ $ _____

_____ _____ $ _____

_____ _____ $ _____

$ _____