2 0 1941

St. 20
Pl.
Ave. No. 8

Name of Owner

Labor and Mat'l. Report Apr 24 1941

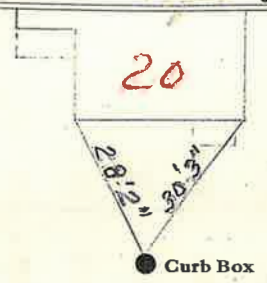

4 Gal Main

Elev. of Main at tap 6

Gate at

Gate at

TAX ID # 303.17-12-4

Curb Box

LABOR AND MATERIALS

1	Copper ~~Lead~~ Connection 3/4	$ 1.35
1	Curb Cock ~~Valve T. S. & V.~~ 3/4 in.	$ 1.80
1	Service Box Old returned Short 3½x4½ ~~Long 4½x5½~~ ~~Buff or Rdway~~	$ 1.70
14	Ft. 3/4 in. Copper ~~Galv Iron~~ ~~Cast Iron~~ Pipe at 15	$ 2.52
	Nipples ... in. at	$
	Bushings ... to ... in. at	$
	Red'g Inc'g Couplings ... to ... in. at	$
	Union ... in. at	$
	Meter ... in. at	$
	Lead Joints at	$
	Leadite Joints at	$
	Hrs. Foreman at	$
4	Hrs. Chauffeur at 62½c	$ 2.50
8	Hrs. Tapper at ?	$ 5.—
13	Hrs. Labor at 45	$ 5.85
	Hrs. Labor at	$
1	Hrs. Compressor at 62½c	$ .63
	Compensation Ins.	$ .41
	Trucking	$ 1.—
	Builders Use of Water Patch	$ 9.00
	Tap by Hand	$
		$
		$
		$
		$ 31.74