LABOR AND MATERIALS

PEX
~~Copper~~ ~~Lead~~ } Connection _____ $ _____

3/4 Curb } Cock / Valve / T.S. & V. } _____ in. _____ $ _____

_____ Service box / Old returned { Short 3-1/2 x 4-1/2 / Long 4-1/2 x 5-1/2 } _____ $ _____

24 Ft. 11 in. { ~~Copper~~ / ~~C.I.~~ / ~~C.I.~~ PEX } Pipe at _____ $ _____

_____ Nipples _____ in. at _____ $ _____

_____ Bushings _____ to _____ in. at _____ $ _____

_____ Red'g

_____ Inc'g

_____ Union _____ in. at _____ $ _____

_____ Meter _____ in. at _____ $ _____

_____ _____ $ _____

_____ Compound Joints at _____ $ _____

_____ Maintenance Foreman _____ $ _____

_____ Hrs. Water Maint. Man - 1 at _____ $ _____

_____ Hrs. Water Maint. Man - 2 at _____ $ _____

_____ Hrs. Garage Foreman _____ at _____ $ _____

_____ Hrs. Labor _____ at _____ $ _____

_____ Hrs. Compressor at _____ $ _____

_____ _____ $ _____

_____ Trucking _____ $ _____

_____ Pav't Patch _____ $ _____

_____ _____ $ _____

_____ _____ $ _____

_____ _____ $ _____

_____ _____ $ _____

$ _____

CorTLmd

Name of Owner

~~St.~~ ~~Pl.~~ Ave. No. 22

Labor and Mat'l. Report ~~19~~ 9/25/13

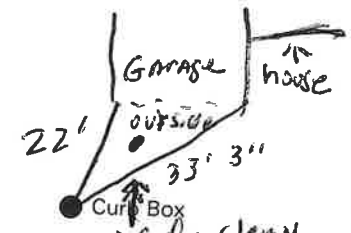

6" Main

Elev. of Main at tap 4' 6"

Gate at ●

● Gate at

● Curb Box