Labor and Materials

1 ~~Copper~~ Lead } Connection 1/2 ..... $.....

1 Curb { Cock / ~~Valve~~ / T. S. & V. } 3/4 in ..... $.....

1 Service Box Old returned { Short 3½ x 4½ / Long ~~4½ x 5½~~ / ~~Buff. or~~ Rdway } ..... $.....

13 Ft. 3/4 in. { ~~Copper~~ / Galv Iron / ~~Cast Iron~~ } Pipe at ..... $.....

..... Nipples ..... in. at ..... $.....

..... Bushings ..... to ..... in. at ..... $.....

Red'g / Inc'g { Couplings ..... to ..... in. at ..... $.....

..... Union ..... in. at ..... $.....

..... Meter ..... in. at ..... $.....

..... Lead Joints at ..... $.....

..... Leadite Joints at ..... $.....

..... Hrs. Foreman at ..... $.....

..... Hrs. Chauffeur at ..... $.....

..... Hrs. Tapper at ..... $.....

..... Hrs. Labor at ..... $.....

..... Hrs. Labor at ..... $.....

..... Hrs. Compressor at ..... $.....

..... Compensation Ins. ..... $.....

..... Trucking ..... $.....

..... Builders Use of Water ..... $.....

..... $.....

..... $.....

..... $.....

..... $.....

$.....

Grandall St. / ~~Pl.~~ / Ave. No. 15

Name of Owner

HB Seaman

Tapped Jun 15

Labor and Mat'l. Report 19 21

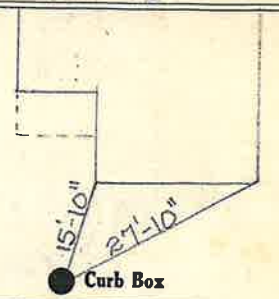

8" ?
12"
..... Main

Elev. of Main at tap ..... 5' .....

Gate at ●

● Gate at

● Curb Box