LABOR AND MATERIALS

1 ~~Copper~~ / Lead } Connection ____ $____

1 Curb { Cock / ~~Valve~~ / ~~T. S. & V.~~ } ____ in. ____ $____

____ Service box / Old returned { Short 3½ x 4½ / Long 4½ x 5½ / Buff or Rdway } ____ $____

5 Ft. 1 in. { ~~Copper~~ / G. I. / ~~C. I.~~ } Pipe at ____ $____

____ Nipples ____ in. at ____ $____

____ Bushings ____ to ____ in. at ____ $____

____ { Red'g / Inc'g } Coupl'gs ____ to ____ in. at ____ $____

____ Union ____ in. at ____ $____

____ Meter ____ in. at ____ $____

____ Lead Joints at ____ $____

____ Compound Joints at ____ $____

____ Maintenance Foreman ____ $____

____ Hrs. Water Maint. Man—1 at ____ $____

____ Hrs. Water Maint. Man—2 at ____ $____

____ Hrs. Garage Foreman ____ at ____ $____

____ Hrs. Labor— ____ at ____ $____

____ Hrs. Compressor at ____ $____

____ Compensation Ins. at $____ per C ____ $____

____ Trucking ____ $____

____ Pav't Patch ____ $____

____ $____

____ $____

____ $____

____ O'head ____ $____

$____

Crandall St. / ~~Pl.~~ / ~~Ave.~~ No. 27

Name of Owner

Labor and Mat'l. Report 1924

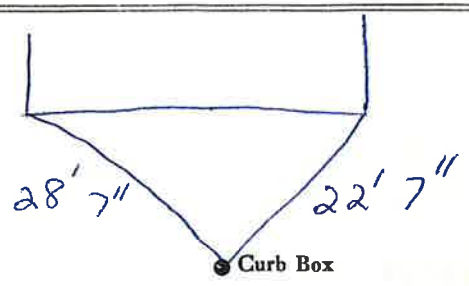

10" Main Elev. of Main at tap 4'

Gate at ● ● Gate at

● Curb Box

LSM—5C—6-1-67