Labor and Material Report 8/6 19

49 Crandell St Vac Lot

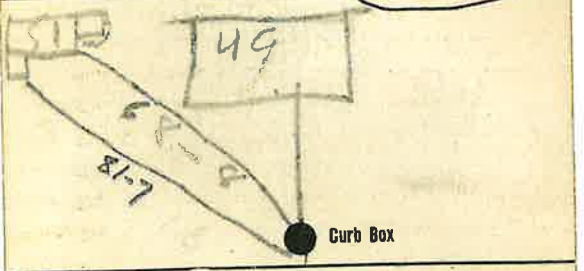

10 Main

Elev. of Main at tap 4

Gate at ● ● Gate at

Lot

Tap

Labor and Materials

1	Lead Connection	$
1	Curb Cock 1	$
1	Service Box { Short 3½ x 4½ / Long 4½ x 5½ / Buffalo / Old returned }	$
6	Ft. 1 in. G. I. Pipe at	$
	Nipples in. at	$
	Bushings to in. at	$
	Red'g Coup to in. at	$
	Inc'g Coup to in. at	$
	Union in. at	$
	Meter in. at	$
	Cu. Yds. Br. Stone at	$
	Cu. Yds. Sand at	$
	Bags Cement at	$
	Paving Brick { Mack / Red / Asphalt } at	$
2	Hrs. Foreman at	$
6	Hrs. Common Labor at	$
	Hrs. Mason at	$
	Hrs. at	$
	Hrs. at	$
2.0	Builders' Use of Water	$
	at	$
	Truck 100 at	$
	at	$
	at	$
	Total	$ 1985