LABOR AND MATERIALS

1 Copper / ~~Lead~~ } Connection 3/4" $

1 Curb { Cock / ~~Valve~~ / ~~T. S. & V.~~ } 3/4 in. $

1 Service box / ~~Old returned~~ { ~~Short 3½ x 4½~~ / Long 4½ x 5½ / ~~Buff or Rdway~~ } $

11 Ft. 3/4 in. { Copper / ~~G. I.~~ / ~~C. I.~~ } Pipe at $

Nipples in. at $

Bushings to in. at $

Red'g / Inc'g } Coupl'gs to in. at $

Union in. at $

Meter in. at $

Lead Joints at $

Compound Joints at $

Maintenance Foreman $

Hrs. Water Maint. Man—1 at $

Hrs. Water Maint. Man—2 at $

Hrs. Garage Foreman at $

Hrs. Labor— at $

Hrs. Compressor at $

Compensation Ins. at $ per C $

Trucking $

Pav't Patch $

Tap by Lareaut Co $

8-22-67. $

O'head $

$

St. / ~~Pl.~~ / ~~Ave.~~ Crandall No. 59

Name of Owner

Lynn Chase.

Labor and Mat'l. Report Aug. 22 1967

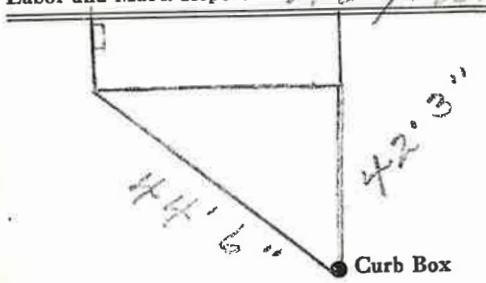

10" Main

Elev. of Main at tap 5'

Gate at ●

● Gate at

TAX ID # 302.20-3-18

● Curb Box

LSM—BC—8-10-61