## LABOR AND MATERIALS

| | | |
|---|---|---|
| 1 | Copper ~~Lead~~ Connection | $ 1.31 |
| 1 | Curb { Cock ~~Valve~~ ~~T. S. & V.~~ } 3/4 in. | $ 1.75 |
| 1 | Service Box Old returned { Short 3½x4½ ~~Long 4½x5½~~ ~~Buff. or Rdway~~ } | $ 1.60 |
| 15 Ft. 3/4 in. | { Copper ~~Galv Iron~~ ~~Cast Iron~~ } Pipe at 18 | $ 2.70 |
| | Nipples ____ in. at | $ |
| | Bushings ____ to ____ in. at | $ |
| | Red'g Inc'g Couplings ____ to ____ in. at | $ |
| | Union ____ in. at | $ |
| | Meter ____ in. at | $ |
| | Lead Joints at | $ |
| | Leadite Joints at | $ |
| | Hrs. Foreman at | $ |
| 2¾ | Hrs. Chauffeur at 1.24 | $ 1.72 |
| 5 | Hrs. Tapper at | $ 3.13 |
| 15 | Hrs. Labor at 45 | $ 6.75 |
| | Hrs. Labor at | $ |
| | Hrs. Compressor at | $ |
| | Compensation Ins. | $ .36 |
| | Trucking | $ 1.— |
| | Builders Use of Water | $ |
| Tap by Hessel | | $ |
| | | $ |
| | | $ |
| | | $ |

$20.32

1 6 4 - 1940

St. 14 A-B

~~Pl.~~

Culvert Ave. No. 8410

**Name of Owner**

Bassinger

**Labor and Mat'l. Report** Oct 15 1940

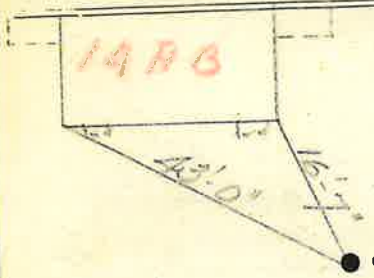


Eagle Main

Elev. of Main at tap 5½'

Gate at

Gate at

Curb Box