LABOR AND MATERIALS

1	Copper / ~~Lead~~ Connection	3/4"	$ 2.29
1	Curb — Cock / ~~Valve~~ / ~~T. S. & V.~~	3/4" in.	$ 2.70
1	Service box — Short 3½x4½ / ~~Long 4½x5½~~ / Buff or Rdway / ~~Old returned~~		$ 4.25
9	Ft. 3/4 in. — Copper / ~~G. I.~~ / ~~C. I.~~ Pipe at	35	$ 3.15
	Nipples	in. at	$
	Bushings	to in. at	$
	Red'g / Inc'g Coupl'gs	to in. at	$
	Union	in. at	$
	Meter	in. at	$
	Lead Joints at		$
	Compound Joints at		$
1	Hrs. Water Maint. Man—1 at		$ 1.12
1	Hrs. Water Maint. Man—2 at		$ 1.07
10	Hrs. Labor— at		$ 9.10
	Hrs. Labor— at		$
	Hrs. Compressor at		$
	Compensation Ins. at $ per C.		$ .25
	Trucking		$ 1.00
	Pav't Patch		$
	Tap by Warsinski		$
			$
			$
	O'head		$
			$ 24.88

186-1950 Before Paving ✓

St.
Pl.
Division Ave. No. 14

Name of Owner

J. Wm Cronkhite

Labor and Mat'l. Report Aug. 23 1950

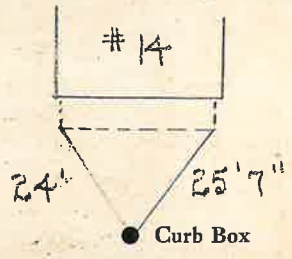

4" Main

Elev. of Main at tap 5'

Gate at ● ● Gate at

● Curb Box

LSM-5C 10-21-49