LABOR AND MATERIALS

1	Copper / ~~Lead~~ Connection	3/4"	$ 2.29
1	Curb — Cock / ~~Valve~~ / ~~T. S. & V.~~	3/4" in.	$ 2.70
1	Service box — ~~Old returned~~ — Short 3½x4½ / ~~Long 4½x5½~~ / Buff or Rdway		$ 4.25
14	Ft. 3/4 in. — Copper / ~~C. I.~~ / ~~C. I.~~	Pipe at 35	$ 4.90
	Nipples	in. at	$
	Bushings	to in. at	$
	Red'g / Inc'g Coupl'gs	to in. at	$
	Union	in. at	$
	Meter	in. at	$
	Lead Joints at		$
	Compound Joints at		$
1	Hrs. Water Maint. Man—1 at		$ 1.12
1	Hrs. Water Maint. Man—2 at		$ 1.02
10	Hrs. Labor—	at	$ 9.10
	Hrs. Labor—	at	$
	Hrs. Compressor at		$
	Compensation Ins. at $	per C.	$
	Trucking		$ 1.25
	Pav't Patch		$
	Tap by Warsinski		$
			$
			$
	O'head		$
			$ 26.63

121-1950 Before Paving

J

St. / ~~Pl.~~ Division Ave. No. 4

Name of Owner

Daniel Healey

Labor and Mat'l. Report Aug 22 1950

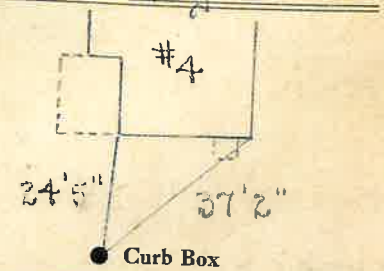

4" Main Elev. of Main at tap 5'

Gate at ● ● Gate at

● Curb Box

LSM-5C 10-21-49