LABOR AND MATERIALS

1	Copper ~~Lead~~ Connection	3/4	$ 1.35
1	Curb { Cock ~~Valve T. S. & V.~~ }	3/4 in.	$ 1.80
1	Service Box ~~Old returned~~ { Short 3½x4½ ~~Long 4½x5½~~ Buff or Rdway }		$ 1.70
11 Ft.	3/4 in. { Copper ~~Galv Iron~~ ~~Cast Iron~~ }	Pipe at 18	$ 1.98
	Nipples ... in. at		$
	Bushings ... to ... in. at		$
	Red'g Inc'g Couplings ... to ... in. at		$
	Union ... in. at		$
	Meter ... in. at		$
	Lead Joints at		$
	Leadite Joints at		$
	Hrs. Foreman at		$
1	Hrs. Chauffeur at	62½	$ .63
2½	Hrs. Tapper at		$ 1.56
9½	Hrs. Labor at	45	$ 4.28
	Hrs. Labor at		$
	Hrs. Compressor at		$
	Compensation Ins.		$ 20
	Trucking		$ 1.—
	Builders Use of Water Mylone Paving		$
	Tapley Messer		$
			$
			$
			$
			$ 14.50

~~St.~~ ~~Pl.~~

Dix Ave. No. 21

Name of Owner

Collins - Frank Lot

Labor and Mat'l. Report Oct 23 1941

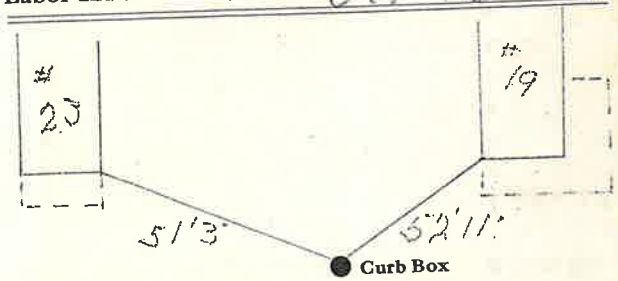

1 Main 1" Elev. of Main at tap 5'-1"

Gate at ● ● Gate at

● Curb Box