LABOR AND MATERIALS

1	Copper ~~Lead~~ Connection	3/4	$ 1.35
1	Curb { Cock ~~Valve~~ ~~T. S. & V.~~ }	3/4 in.	$ 1.80
	Service Box Old returned { Short 3½x4½ Long 4½x5½ Buff or Rdway }	Same	$ —
33	Ft. 3/4 in. { Copper ~~Galv Iron~~ ~~Cast Iron~~ }	Pipe at	$ 5.94
	Nipples	in. at	$
	Bushings	to in. at	$
	Red'g Inc'g } Couplings	to in. at	$
	Union	in. at	$
	Meter	in. at	$
	Lead Joints at		$
	Leadite Joints at		$
	Hrs. Foreman at		$
3 1/4	Hrs. Chauffeur at	62½	$ 2.03
6 1/4	Hrs. Tapper at		$ 3.90
23 1/4	Hrs. Labor at	45	$ 10.46
	Hrs. Labor at		$
1	Hrs. Compressor at		$ .63
	Compensation Ins.		$ .50
	Trucking		$ 1.—
	Builders Use of Water	Before Paving	$ —
	Tap by Hoisel		$
			$
			$
			$
			$ 27.61

1 3 5 1941

~~St.~~
~~Pl.~~

DIX Ave. No. 21

Name of Owner

C.B. Ainsworth

Labor and Mat'l. Report Oct 10 1941

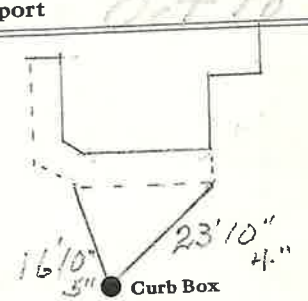

4" Main

Elev. of Main at tap 5'

Gate at

Gate at

Curb Box