LABOR AND MATERIALS

1	Copper ~~Lead~~ Connection 3/4	$ 1.35
1	Curb {Cock ~~Valve~~ ~~T. S. & V.~~} 3/4 in.	$ 1.80
1	Service Box Old returned {Short ~~3½x4½~~ Long 4½x5½ ~~Buff or Rdway~~}	$ 1.70
14	Ft. 3/4 in. {Copper ~~Galv Iron~~ ~~Cast Iron~~} Pipe at 18	$ 2.52
	Nipples in. at	$
	Bushings to in. at	$
	Red'g Couplings to in. at	$
	Union in. at	$
	Meter in. at	$
	Lead Joints at	$
	Leadite Joints at	$
	Hrs. Foreman at	$
1	Hrs. Chauffeur at .67½	$ .63
2½	Hrs. Tapper at	$ 1.56
9½	Hrs. Labor at .45	$ 4.28
	Hrs. Labor at	$
	Hrs. Compressor at	$
	Compensation Ins.	$ .20
	Trucking	$ 1.—
	Builders Use of Water Before Boring Tap by Meter	$ —
		$
		$
		$
		$ 15.04

~~Dec~~ 3 9 1941

~~St.~~ ~~Pl.~~ Dix Ave. No. 31

Name of Owner

Cronin (Katherine)

Labor and Mat'l. Report Oct 10 1941

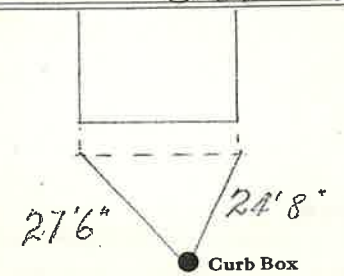

6 Main

Elev. of Main at tap 5-

Gate at ●

● Gate at

● Curb Box