LABOR AND MATERIALS

1	Copper ~~Lead~~ Connection	3/4	$ 1.35
1	Curb { Cock ~~Valve~~ ~~T. S. & V.~~ }	3/4 in.	$ 1.80
1	Service Box Old returned { ~~Short 3½x4½~~ Long 4½x5½ ~~Buff or Rdway~~ }		$ 1.70
13 Ft. 3/4 in.	{ Copper ~~Galv Iron~~ ~~Cast Iron~~ }	Pipe at 18	$ 2.34
	Nipples ..... in. at		$
	Bushings ..... to ..... in. at		$
	Red'g Inc'g Couplings ..... to ..... in. at		$
	Union ..... in. at		$
	Meter ..... in. at		$
	Lead Joints at		$
	Leadite Joints at		$
	Hrs. Foreman at		$
1	Hrs. Chauffeur at	62½	$ 63
2½	Hrs. Tapper at	?	$ 1.56
9½	Hrs. Labor at		$ 4.28
	Hrs. Labor at		$
	Hrs. Compressor at		$
	Compensation Ins.		$ .20
	Trucking		$ 1.—
	Builders Use of Water Before Paving		$
	Tap by Hose		$
			$
			$
			$
			$ 14.96

1 4 0 1941

~~St.~~ ~~Pl.~~ Dix Ave. No. 33

Name of Owner

Silverman (Jane)

Labor and Mat'l. Report Oct 10 1941

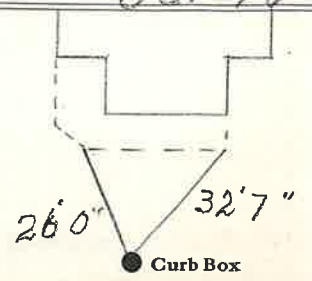

6" Main

Elev. of Main at tap 1'—

Gate at ● ● Gate at

● Curb Box