LABOR AND MATERIALS

1 Copper ~~Lead~~ } Connection 3/4" $

1 Curb } Cock ~~Valve~~ ~~T.S.&V.~~ } 3/4 in. (MARK II OR I COM I) $

1 Service box Old returned { Short 3½ x 4½ ~~Long 4½ x 5½~~ ~~Buff or Rdway~~ } $

38 Ft. 3/4 in. { Copper ~~Cpl.~~ ~~Gal.~~ } Pipe at $

Nipples in. at $

Bushings to in. at $

Red'g Inc'g } Coupl'gs to in. at $

Union in. at $

Meter in. at $

Lead Joints at $

Compound Joints at $

Maintenance Foreman $

Hrs. Water Maint. Man—1 at $

Hrs. Water Maint. Man—2 at $

Hrs. Garage Foreman at $

Hrs. Labor— at $

Hrs. Compressor at $

Compensation Ins. at $ per C $

Trucking $

Pav't Patch $

$

Tap Made By St. John $

$

O'head Nov-14-1973 $

$

Dix ~~St.~~ ~~Pl.~~ Ave. No. 120

Name of Owner

Ronald Coumbe

Labor and Mat'l. Report Nov 14 1973

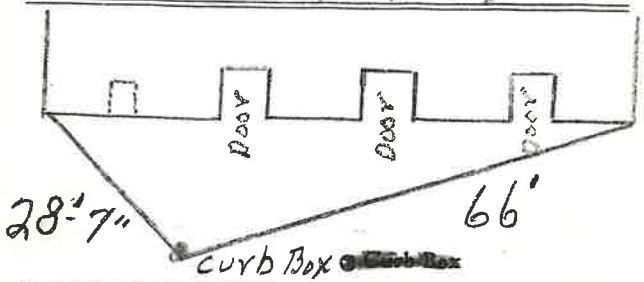

6" Main

Elev. of Main at tap 5½'

Gate at ●

● Gate at

● Curb Box

LSM—5C—6-1-67