LABOR AND MATERIALS

1	Copper Lead } Connection	3/4	$ 1.35
1	Curb { Cock Valve T. S. & V. }	3/4 in.	$ 1.80
	Service Box Old returned { Short 3½x4½ Long 4½x5½ Buff or Rdway }	Gains	$ —
34 Ft.	3/4 in. { Copper Galv Iron Cast Iron } Pipe at		$ 6.12
	Nipples	in. at	$
	Bushings	to in. at	$
	Red'g Inc'g } Couplings	to in. at	$
	Union	in. at	$
	Meter	in. at	$
	Lead Joints at		$
	Leadite Joints at		$
	Hrs. Foreman at		$
3¼	Hrs. Chauffeur at	62½	$ 2.03
6¼	Hrs. Tapper at	4	$ 3.90
23¼	Hrs. Labor at	45	$ 10.46
	Hrs. Labor at		$
1	Hrs. Compressor at	62½	$ .63
	Compensation Ins.		$ .50
	Trucking		$ 1.—
	Builders Use of Water	Before Paving	$ —
Tap by Hessel			$
			$
			$
			$
			$ 7.79

1 3 0 1941

St. Dix Pl. Ave. No. 14

Name of Owner

Levack (Harold)

Labor and Mat'l. Report Oct 14 1941

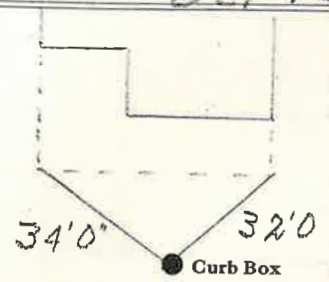

1¼" Main

Elev. of Main at tap 5'1"

Gate at ● ● Gate at

TX ID # 303.13-8-45

● Curb Box