LABOR AND MATERIALS

1	Copper / ~~Lead~~ Connection	3/4	$ 2.94
1	Curb — Cock / ~~Vaire~~ / ~~T. S. & V.~~	3/4 in.	$ 3.71
1	Service box — Old returned — Short ~~3½X4½~~ / Long 4½X5½ / ~~Buff or Rdway~~		$ 5.90
23	Ft. 3/4 in. — Copper / ~~C. I.~~ / ~~C. I.~~ Pipe at 30		$ 6.90
	Nipples ... in. at		$
	Bushings ... to ... in. at		$
	Red'g Inc'g Coupl'gs ... to ... in. at		$
	Union ... in. at		$
	Meter ... in. at		$
	Lead Joints at		$
	Compound Joints at		$
	Hrs. Water Maint. Man—1 at		$
3	Hrs. Water Maint. Man—2 at	91	$ 2.73
	Hrs. Labor— ... at		$
	Hrs. Labor— ... at		$
	Hrs. Compressor at		$
	Compensation Ins. at $ ... per C		$ .06
	Trucking		$ 1.50
	Pav't Patch		$ 17.80
	Tap by Mogavero		$
			$
			$
	O'head		$
			$ 41.04

95

St. Pl. Ave. No. Elm 28430

Name of Owner

Lebowitz

Labor and Mat'l. Report July 26 1948

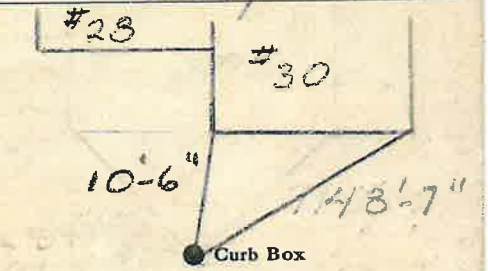

remeasured 1977

6" Main

Elev. of Main at tap 6"

Gate at

Gate at

Curb Box

LSM-SC 5 15-48

Old Tap dug up + Shut off Jake 7-9