## LABOR AND MATERIALS

| | | |
|---|---|---|
| 1 | Copper / ~~Lead~~ Connection 3/4 | $ 2.87 |
| 1 | Curb — Cock / ~~Valve~~ / ~~T. S. & V.~~ 3/4 in. | $ 3.62 |
| 1 | Service box — Old returned — ~~Short 3½X4½~~ / Long 4½X5½ / ~~Buff or Rdway~~ | $ 4.68 |
| 24 | Ft. 3/4 in. — ~~Copper~~ / ~~C. I.~~ Pipe at 32 | $ 7.68 |
| | Nipples in. at | $ |
| | Bushings to in. at | $ |
| | Red'g Inc'g Coupl'gs to in. at | $ |
| | Union in. at | $ |
| | Meter in. at | $ |
| | Lead Joints at | $ |
| | Compound Joints at | $ |
| 6 | Hrs. Water Maint. Man—1 at 1.12 | $ 6.72 |
| | Hrs. Water Maint. Man—2 at | $ |
| 15 | Hrs. Labor— at 91 | $ 13.65 |
| | Hrs. Labor— at | $ |
| 3 | Hrs. Compressor at 1.20 | $ 3.60 |
| | Compensation Ins. at $ 2.18 per C | $ .44 |
| | Trucking | $ 2.00 |
| | Pav't Patch | $ 14.85 |
| | Tag by Miller | $ |
| | | $ |
| | | $ |
| | O'head | $ |
| | | $ 60.11 |

21

St.
~~Pl.~~
~~Ave.~~ No. 6

Elm

**Name of Owner**

Monsour

**Labor and Mat'l. Report** April 27 19 49

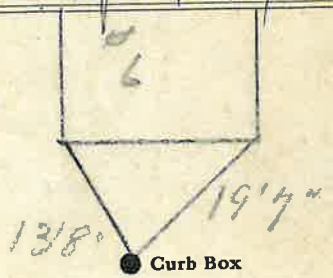


1 11 Main

Elev. of Main at tap 5½ 1

Gate at ●

● Gate at

● Curb Box

LSM-5C 5 15-48