LABOR AND MATERIALS

1 Copper ~~Lead~~ } Connection 3/4 $ 1.31

1 Curb { Cock / ~~Valve~~ / ~~T. S. & V.~~ } 3/4 in. $ 1.75

1 Service Box Old returned { ~~Short 3½x4½~~ / Long 4½x5½ / ~~Buff. or Rdway~~ } $ 1.60

28 Ft. 3/4 in. { Copper / ~~Galv. Iron~~ / ~~Cast Iron~~ } Pipe at 18 $ 5.04

____ Nipples ____ in. at ____ $ ____

____ Bushings ____ to ____ in. at ____ $ ____

____ Red'g / Inc'g } Couplings ____ to ____ in. at ____ $ ____

____ Union ____ in. at ____ $ ____

____ Meter ____ in. at ____ $ ____

____ Lead Joints at ____ $ ____

____ Leadite Joints at ____ $ ____

____ Hrs. Foreman at ____ $ ____

7 Hrs. Chauffeur at 62½ $ 4.37

2¼ Hrs. Tapper at ____ $ 1.56

2½ Hrs. Labor at 45 $ 11.70

____ Hrs. Labor at ____ $ ____

____ Hrs. Compressor at ____ $ ____

____ Compensation Ins. ____ $ .36

____ Trucking ____ $ 1.—

____ Builders Use of Water ____ $ ____

Tap by Miller $ ____

$ ____

$ ____

$ ____

$ 28.69

---

8 - - 1940

St. ~~Pl.~~ Elm Ave. No. 58

Name of Owner

Cowles

Labor and Mat'l. Report June 21 1940

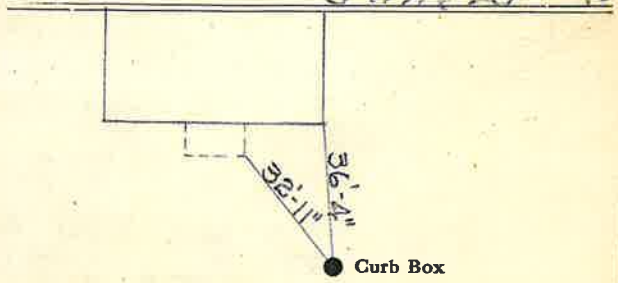

6 Main

Elev. of Main at tap 6

Gate at ● ● Gate at

● Curb Box