LABOR AND MATERIALS

1	Copper ~~Lead~~ Connection	3/4	$ 1.31
1	Curb { Cock ~~Valve~~ ~~T. S. & V.~~ }	3/4 in.	$ 1.75
1	Service Box ~~Old returned~~ { ~~Short 3½x4½~~ Long 4½x5½ ~~Buff. or Rdway~~ }		$ 1.60
10 Ft.	3/4 in. { Copper ~~Galv Iron~~ ~~Cast Iron~~ }	Pipe at 18	$ 1.80
	Nipples ____ in. at		$
	Bushings ____ to ____ in. at		$
	Red'g Inc'g Couplings ____ to ____ in. at		$
	Union ____ in. at		$
	Meter ____ in. at		$
	Lead Joints at		$
	Leadite Joints at		$
	Hrs. Foreman at		$
2 1/2	Hrs. Chauffeur at 62 1/2		$ 1.56
1	Hrs. Tapper at "		$ .63
9	Hrs. Labor at 45		$ 4.05
	Hrs. Labor at		$
	Hrs. Compressor at		$
	Compensation Ins.		$ .19
	Trucking		$ 1.—
	Builders Use of Water		$ —
	Tap by Miller		$
			$
			$
			$
			$ 13.89

8 7 - - 1940

St. ~~Pl.~~ ~~Ave.~~ No. 69

Elm

Name of Owner

V Green

Labor and Mat'l. Report June 19 1940

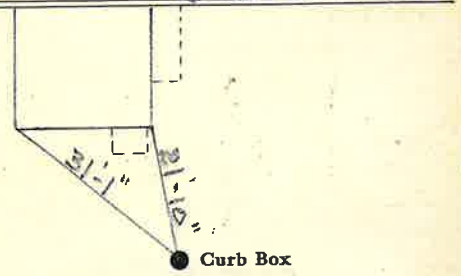

6" Main

Elev. of Main at tap 6'

Gate at ●

● Gate at

● Curb Box