Labor and Materials

Copper Lead } Connection ..... $.....

1 Curb { Cock / ~~Valve~~ / T. S. & V. } 5/8 in ..... $.....

1 Service Box { Short 3½ x 4½ / Long 4½ x 5½ / Buff. or Rdway } Old returned ..... $.....

20 Ft. 3/4 in. { Copper / Galv Iron / Cast Iron } Pipe at ..... $.....

..... Nipples ..... in. at ..... $.....

..... Bushings ..... to ..... in. at ..... $.....

Red'g Inc'g { Couplings ..... to ..... in. at ..... $.....

..... Union ..... in. at ..... $.....

..... Meter ..... in. at ..... $.....

..... Lead Joints at ..... $.....

..... Leadite Joints at ..... $.....

..... Hrs. Foreman at ..... $.....

..... Hrs. Chauffeur at ..... $.....

..... Hrs. Tapper at ..... $.....

..... Hrs. Labor at ..... $.....

..... Hrs. Labor at ..... $.....

..... Hrs. Compressor at ..... $.....

..... Compensation Ins. ..... $.....

..... Trucking ..... $.....

..... Builders Use of Water ..... $.....

..... $.....

..... $.....

..... $.....

$.....

St. / ~~Pl.~~ / ~~Ave.~~ Elm No. 16

Name of Owner

H. Brown

Labor and Mat'l. Report May 27 1918

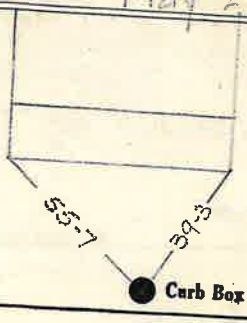

6" Main

Elev. of Main at tap .....

Gate at ●

● Gate at

● Curb Box

House Razed.