LABOR AND MATERIALS

1 Copper ~~Lead~~ } Connection 3/4" $ _____

1 Curb } Cock ~~Valve~~ ~~T.S.&V.~~ } 3/4" in. _____ $ _____

1 Service box ~~Old returned~~ { Short 3-1/2 x 4-1/2 ~~Long 4-1/2 x 5-1/2~~ } _____ $ _____

9' Ft. 3/4" in. { Copper ~~Cast~~ ~~Lead~~ } Pipe at _____ $ _____

_____ Nipples _____ in. at _____ $ _____

_____ Bushings _____ to _____ in. at _____ $ _____

_____ Red'g

_____ Inc'g

_____ Union _____ in. at _____ $ _____

_____ Meter _____ in. at _____ $ _____

_____ _____ $ _____

_____ Compound Joints at _____ $ _____

_____ Maintenance Foreman _____ $ _____

_____ Hrs. Water Maint. Man - 1 at _____ $ _____

_____ Hrs. Water Maint. Man - 2 at _____ $ _____

_____ Hrs. Garage Foreman _____ at _____ $ _____

_____ Hrs. Labor _____ at _____ $ _____

_____ Hrs. Compressor at _____ $ _____

_____ _____ $ _____

_____ Trucking _____ $ _____

_____ Pav't Patch _____ $ _____

_____ _____ $ _____

_____ _____ $ _____

_____ _____ $ _____

_____ _____ $ _____

$ _____

5th St. ~~Pl.~~ ~~Ave.~~ No. 60

Name of Owner

Labor and Mat'l. Report SEPT. 30, 1931

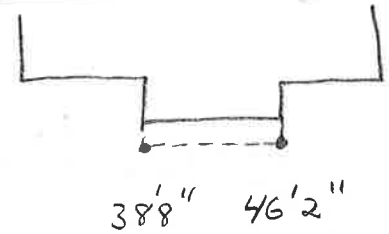

6" Main

Elev. of Main at tap 5'

Gate at ●

● Gate at

_____ _____

● Curb Box