LABOR AND MATERIALS

1	Copper Lead — Connection	3/4	$ 2.80
	Curb — Clock Valve T. S. & V.	3/4 in.	$ 3.60
1	Service box Old returned — Short 3½X4½ / Long 4½X5½ / Buff or Rdway		$ 5.80
9	Ft. 3/4 in. — Copper / Galv. Iron / Cast Iron — Pipe at 35		$ 3.15
	Nipples in. at		$
	Bushings to in. at		$
	Red'g Inc'g — Couplings to in. at		$
	Union in. at		$
	Meter in. at		$
	Lead Joints at		$
	Compound Joints at		$
2	Hrs. Foreman at		$ 2.07
1	Hrs. Chauffeur at		$ 91
	Hrs. Tapper at		$
13	Hrs. Labor at		$ 10 40
	Hrs. Labor at		$
	Hrs. Compressor at		$
	Compensation Ins.		$ 24
	Trucking		$ 1.00
	Builders Use of Water		$
	Tap & Meter		$
			$
			$
			$
			$ 29.97

7047

~~St.~~ ~~Pl.~~ Flandreaux Ave. No. 26

Name of Owner

Fosbrook

Labor and Mat'l. Report July 24 1947

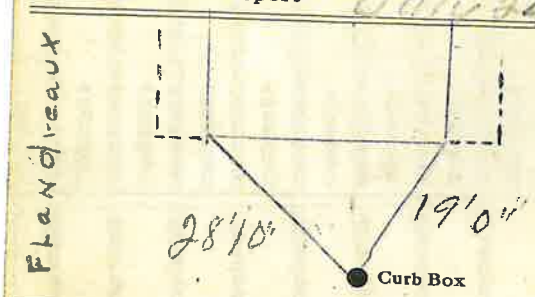

1 Main — Elev. of Main at tap 4'

Gate at ● — ● Gate at

● Curb Box

Tap on Mason St.

LSM-SC-6-1-45