LABOR AND MATERIALS

1	Copper / ~~Lead~~ Connection 3/4	$ 2.87
1	Curb { Cock / ~~Valve~~ / T. S. & V. } 3/4 in.	$ 3.67
1	Service box { Short 3½X4½ / Long ~~4½X5½~~ / Buff or Rdway } Old returned	$ 4.68
22	Ft. 3/4 in. { Copper / ~~G. I.~~ / ~~C. I.~~ } Pipe at 32	$ 7.36
	Nipples ..... in. at	$
	Bushings ..... to ..... in. at	$
	Red'g / Inc'g { Coupl'gs ..... to ..... in. at	$
	Union ..... in. at	$
	Meter ..... in. at	$
	Lead Joints at	$
	Compound Joints at	$
5	Hrs. Water Maint. Man—1 at 1.17	$ 15.60
7	Hrs. Water Maint. Man—2 at 1.07 ✓	$ 7.14
15	Hrs. Labor— ....at 91	$ 13.65
	Hrs. Labor— ....at	$
	Hrs. Compressor at	$
	Compensation Ins. at $ 2.1 per C	$ 0.59
	Trucking	$ 2.00
	Pav't Patch	$
	Tooly Miller	$
		$
		$
	O'head	$
		$ 47.50

70

Fulton St. Pl. Ave. No. 11

Name of Owner

Grandy

Labor and Mat'l. Report June 27 1949

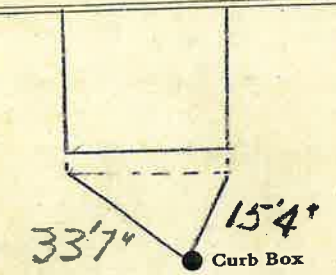

10 Main

Elev. of Main at tap 5'

Gate at ● ● Gate at

● Curb Box

LSM-5C 5 18-48

To be Billed ✓

LABOR AND MATERIALS

Copper / Lead } Connection ..... $.....

Curb { Cock / Valve / T. S. & V. } ..... in. ..... $.....

Service Box / Old returned { Short 3½x4½ / Long 4½x5½ / Buff or Rdway } ..... $.....

..... Ft. ..... in. { Copper / Galv Iron / Cast Iron } Pipe at ..... $.....

..... Nipples ..... in. at ..... $.....

..... Bushings ..... to ..... in. at ..... $.....

Red'g / Inc'g } Couplings ..... to ..... in. at ..... $.....

..... Union ..... in. at ..... $.....

..... Meter ..... in. at ..... $.....

..... Lead Joints at ..... $.....

..... Leadite Joints at ..... $.....

..... Hrs. Foreman at ..... $.....

..... Hrs. Chauffeur at ..... $.....

..... Hrs. Tapper at ..... $.....

..... Hrs. Labor at ..... $.....

..... Hrs. Labor at ..... $.....

..... Hrs. Compressor at ..... $.....

..... Compensation Ins. ..... $.....

..... Trucking ..... $.....

..... Builders Use of Water ..... $.....

..... $.....

..... $.....

..... $.....

..... $.....

$.....

St. 11
Pl.
FULTON ST Ave. No. 11A

Name of Owner

OATMAN (2 FAMILY)

Labor and Mat'l. Report OCT 28 1941

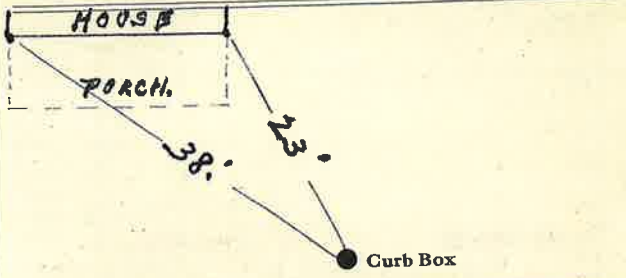

..... Main

Elev. of Main at tap .....

Gate at ●

● Gate at

● Curb Box