65 - 54

LABOR AND MATERIALS

1	Copper ~~Lead~~ Connection	3/4"	$ 2.41
1	Curb { Cock ~~Valve~~ ~~T.S. & V.~~ }	3/4 in.	$ 3.41
1	Service box { Short 3½ x 4½ ~~Long 4½ x 5½~~ ~~Old returned~~ ~~Buff or Rdway~~ }		$ 4.18
22	Ft. 3/4 in. { Copper ~~C.I.~~ ~~C.I.~~ } Pipe at 41		$ 8.90
	Nipples in. at		$
	Bushings to in. at		$
	Red'g Inc'g Coupl'gs to in. at		$
	Union in. at		$
	Meter in. at		$
	Lead Joints at		$
	Compound Joints at		$
	Maintenance Foreman		$
	Hrs. Water Maint. Man—1 at		$
12	Hrs. Water Maint. Man—2 at	1.24	$ 14.88
	Hrs. Garage Foreman at		$
24	Hrs. Labor— at	1.13	$ 27.12
	Hrs. Compressor at		$
	Compensation Ins. at $ 3.961 per C		$ 1.62
	Trucking		$ 1.50
	Pav't Patch		$ 1.92
Tap by Gissgord 9-13-54			$
			$
			$
	O'head		$
			$ 81.84

63.92

St. ~~Pl.~~ ~~Ave.~~ No. 19

Fulton

Name of Owner

Conlin

Labor and Mat'l. Report Sept. 13 1954

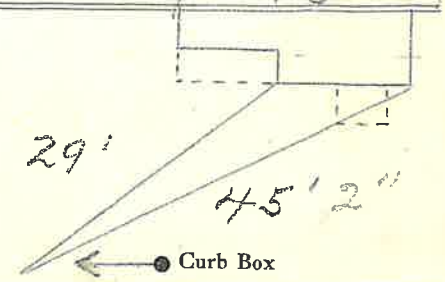

10" Main

Elev. of Main at tap 5 1/2"

Gate at •

• Gate at

• Curb Box

L. M—SC—2-1-54