## LABOR AND MATERIALS

| | | | |
|---|---|---|---|
| 1 | Copper ~~Lead~~ Connection | 3/4 | $ 2.80 |
| 1 | Curb { Clock ~~Valve~~ ~~L. S. & Y.~~ } | 3/4 in. | $ 3.60 |
| 1 | Service box Old returned { Short 3½X4½ ~~Long 4½X5½~~ Buff or Rdway } | | $ 5.80 |
| 24 Ft. | 3/4 in. { Copper ~~Galv. Iron~~ ~~Cast Iron~~ } | Pipe at 35 | $ 8.40 |
| | Nipples | in. at | $ |
| | Bushings | to in. at | $ |
| | Red'g Inc'g Couplings | to in. at | $ |
| | Union | in. at | $ |
| | Meter | in. at | $ |
| | Lead Joints at | | $ |
| | Compound Joints at | | $ |
| | Hrs. Foreman at | | $ |
| 8 | Hrs. Chauffeur at | 91 | $ 7.28 |
| | Hrs. Tapper at | | $ |
| 16 | Hrs. Labor at | 80 | $ 12.80 |
| | Hrs. Labor at | | $ |
| 1 | Hrs. Compressor at | | $ 88 |
| | Compensation Ins. | | $ 44 |
| | Trucking | | $ 1.— |
| | Builders Use of Water | | $ 9.30 |
| Tapp Watson | S/Fc | | $ |
| | | | $ |
| | | | $ |
| | | | $ |
| | | | $ 52.30 |

113-47

St. ~~Pl.~~ ~~Ave.~~ No. 21

Fulton

**Name of Owner**

McDonald

**Labor and Mat'l. Report** Aug 22 1947

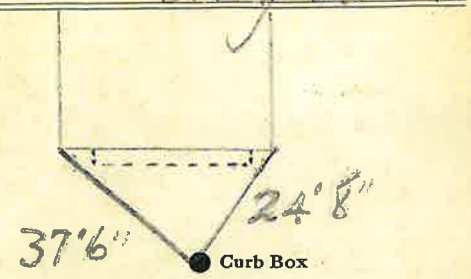


10" Main

Elev. of Main at tap 6'

Gate at ●

● Gate at

● Curb Box

LSM-5C-6-1-45